ENCROACHMENT LICENSE AGREEMENT

THIS ENCROACHMENT LICENSE AGREEMENT ("Agreement") is made and entered into at Erie
Colorado this day of, 2017, by and between the TOWN OF ERIE, a Colorado Municipa
Corporation, whose address P.O. Box 750, 645 Holbrook Street, Erie, Colorado 80516, hereinafter referred
to as "Town" and Boulder Valley School District, whose address is 6500 Arapahoe Road, Boulder, Colorado 80303
hereinafter referred to as "Owner".

RECITALS

- A. Owner is the owner of a Fiber Optic Line. ("Owner's Property").
- B. Town is the owner of the following real property situate in the County of Boulder and State of Colorado, to wit: Tract C and Tract E, Orchard Glen Filing No 1 At Meadow Sweet Farm and Meadow Sweet Lane right of way from the west side of Meadow View Parkway to the east side of the access drive for the Boulder Valley School District Meadowlark School site. See Exhibit "A," attached hereto and incorporated herein by this reference ("Town's Property").
- C. A portion of the Owner's Property and improvements encroaches into and on the Town's Property (the "Encroachment"), as shown on the attached Exhibit "A," and as shown on the construction plans Exhibit "B," which is incorporated herein by reference.
- D. The Town has agreed to grant to Owner a personal privilege to maintain the Encroachment described above on the Town's Property, all in accordance with, and subject to the terms, conditions and limitations of, this Agreement.
- 1. <u>Grant of License</u>. The Town hereby grants to the Owner the personal privilege and permission to enter upon the Town's Property and to maintain the Encroachment described above on the Town's Property subject, however, to the terms, conditions and limitations of this Agreement (the "License"). The License herein granted shall be subject to all existing utility easements, if any, located on or under the Town's Property.
- 2. <u>Term.</u> This Agreement and the License granted to Owner hereunder shall commence as of the date of this Agreement and shall continue until terminated pursuant to Paragraph 9 of this Agreement.
- 3. <u>Consideration</u>. The consideration to be paid by the Owner to the Town for the License and privilege granted by this Agreement shall be One Thousand Dollars (\$1,000.00), receipt of which is hereby acknowledged by the Town, and other good and valuable consideration as herein provided.
- 4. <u>No Interest In Land</u>. Owner understands, acknowledges and agrees that the License and this Agreement do not create an interest or estate in Owner's favor in the Town's Property. The Town retains legal possession of the full boundaries of Town's Property and the License and this Agreement merely grant to the Owner the personal privilege to maintain the Encroachment described above throughout the term of this Agreement.

Notwithstanding the expenditure of time, money or labor by the Owner on the improvements which constitute the Encroachment, the License and this Agreement shall in no event be construed to create an assignment coupled with an interest in favor of the Owner. Owner shall expend any time, money or labor at Owner's own risk and peril.

5. <u>Limited Scope of License</u>. The License granted to the Owner is limited in scope to the following permitted use or uses: <u>maintain and operate a fiber optic line and appurtenances</u>. Owner shall not have the right to expand the License, the Encroachment or Owner's use of the Town's Property or to alter or change the Owner's use of the Town's Property.

- 6. <u>Use of Licensed Premises By Others.</u> Owner may permit Owner's employees, business invitees, contractors, tenants, subcontractors, lessees, agents, customers and others to use the portion of the Town's Property for which the License and this Agreement has been executed.
- 7. <u>Transferability of License</u>. The License granted to the Owner by this Agreement may be transferred to a subsequent owner of Owner's Property; provided, however, that such subsequent owner shall be required to assume in writing all of Owner's obligations hereunder (in a form acceptable to Town) and such subsequent owner shall acquire nothing more than the personal privilege herein granted to Owner. Further, the rights of any subsequent owner shall be subject to termination in accordance with the provisions of Paragraph 9 of this Agreement.
- 8. <u>Default</u>. In the event either party materially defaults in the performance of any of the material covenants or agreements to be kept, done or performed by it under the terms of this Agreement, the non-defaulting party shall notify the defaulting party in writing of the nature of such default. Within five (5) days following receipt of such notice the defaulting party shall correct such default; or, in the event of a default not capable of being corrected within five (5) days, the defaulting party shall commence correcting the default within five (5) days of receipt of notification thereof and thereafter correct the default with due diligence. If the defaulting party fails to correct the default as provided hereinabove, the non-defaulting party, without further notice, shall have the right to declare that the License and this Agreement are terminated pursuant to Paragraph 9 hereof effective upon such date as the non-defaulting party shall designate. The rights and remedies provided for herein may be exercised singly or in combination.
- 9. <u>Termination</u>. This Agreement and the License herein granted to Owner is fully terminable in accordance with the following terms and conditions:
- a. <u>Termination Upon Notice To Owner</u>. This Agreement, and the License herein granted to Owner, may be terminated by Town, at the Town's sole discretion, without liability for breach of this Agreement by the giving of thirty (30) days' advance written notice to Owner. The notice provision established by this paragraph 9(a) shall conclusively be deemed to be reasonable.
- b. <u>Termination Upon Destruction Or Removal Of Improvements</u>. In the event that Owner's improvements which encroach onto the Town's Property are destroyed or are permanently removed, this Agreement, and the License herein granted to Owner, may be terminated by Town upon not less than thirty (30) days' advance written notice to Owner.
- c. <u>Termination Upon Default</u>. This Agreement and the License herein granted to Owner may be terminated by either party upon the material default of the other party in the performance of the material covenants or agreements of this Agreement in accordance with the revisions of Paragraph 8 of this Agreement.
- d. <u>Recording Of Notice Of Termination</u>. Upon termination of the License and this Agreement the Town may cause to be recorded with the Clerk and Recorder of Boulder/Weld County, Colorado a written Notice of Termination.
- e. <u>No Compensation To Owner</u>. In the event of termination of the License and this Agreement for any reason, Owner shall not be entitled to receive a refund of any portion of the consideration paid for the License and this Agreement, nor shall Owner be compensated for any improvements which must be removed from the Town's Property.
- 10. <u>Permanent Removal Of Encroachment Upon Termination</u>. At such time as this Agreement and the License herein granted to Owner is terminated the Owner shall remove, at Owner's sole expense, any and all Encroachments owned or maintained by Owner on the Town's Property.
- 11. <u>Insurance</u>. Owner shall obtain and maintain at all times during the term hereof, at Owner's sole cost, a policy or policies of comprehensive general liability insurance with limits of coverage of not less than \$1,000,000 for injuries, damages or losses sustained by any one person in any one accident or event, and not less than

\$1,000,000 for injuries, damages or losses incurred by two or more persons in any one accident or event. The Town shall be named as an additional insured on all such policies and Owner shall furnish the Town with a copy of such policy or policies prior to the effective date hereof. Notwithstanding anything contained herein to the contrary, Town may terminate this Agreement, and the License herein granted to Owner, in accordance with the provisions of Paragraphs 8 and 9 of this Agreement, if Owner fails to procure and maintain the insurance required by this Paragraph 11. If at any time while the Agreement is in effect, the limits of liability for local governments under the Colorado Governmental Immunity Act, Section 24-10-101, *et seq.*, C.R.S., are raised above the limits of liability provided hereinabove, Owner's insurance requirement provided in this Paragraph 11 shall be increased accordingly.

- 12. <u>Maintenance</u>. During the term of this Agreement the Owner shall, at Owner's sole expense, maintain the improvements which encroach onto the Town's Property in safe and good condition.
- 13. Owner's Waiver Of Claims Against Town. As a part of the consideration paid by Owner for the License and this Agreement, Owner hereby waives any and all claims which Owner may or might hereafter have or acquire against Town for loss or damage to the Owner's improvements which encroach onto the Town's Property arising from the use by the Town, or the public, of the Town's Property for any purpose.
- 14. <u>Indemnification</u>. Owner agrees to indemnify and hold harmless the Town, its officers, employees, insurers, and insurer, from and against all liability, claims, and demands, on account of injury, loss, or damage, including without limitation claims arising from bodily injury, sickness, disease, death, property loss or damage, or any other loss of any kind whatsoever, which arise out of or are in any manner connected with the use of the Town's Property pursuant to the License and this Agreement, if such injury, loss, or damage is caused in whole or in part by, or is claimed to be caused in whole or in part by, the negligence of Owner, any contractor or subcontractor of the Owner, or any officer, employee, tenant, agent, customer, or representative of the Owner, or of any person permitted or allowed to use the Town's Property by Owner, or which arise out of any worker's compensation claim of any employee of the Owner or of any subcontractor of the Owner or of any tenant of Owner; except to the extent such liability, claim or demand arises through the negligence of Town, its officers, employees or agents. Owner agrees to investigate, handle, respond to, and to provide defense for and defend against any such liability, claims or demands at the sole expense of the Owner. Owner also agrees to bear all other costs and expenses related thereto, including court costs and attorney fees.
- 15. <u>Mechanics' Liens</u>. Owner shall not allow any mechanics' or similar liens to be filed against the Town's Property arising from any work done by Owner on the Town's Property, and Owner shall indemnify and hold Town harmless with respect thereto, including any attorney's fees incurred by Town in connection with any such lien or claim. If any mechanics' or other liens shall be created or filed against the Town's Property by reason of labor performed by, or materials furnished for, the Owner, the Owner shall, within ten (10) days thereafter, at the Owner's own cost and expense, cause such lien or liens to be satisfied and discharged of record together with any Notices Of Intention To File Mechanic's Lien that may have been filed. Failure to do so shall constitute a default hereunder for which the Town may terminate this Agreement in accordance with the provisions of Paragraphs 8 and 9 of this Agreement.
- 16. <u>Notices</u>. Any notice required or permitted under this Agreement shall be in writing and shall be sufficient if personally delivered or mailed by certified mail, return receipt requested, addressed to the following:

If To The Town:	Town Administrator
	Town of Erie
	P.O. Box 750
	Erie, Colorado 80516

If To The Owner:

Boulder Valley School District
ATTN: Legal Department

6500 Arapahoe Boulder, CO 80303 Notices mailed in accordance with the provisions of this Paragraph shall be deemed to have been given upon mailing. Notices personally delivered shall have been deemed to have been given upon delivery. Either party may change its address by giving notice thereof to the other party in the manner provided in this Paragraph 16.

- 17. <u>Attorney's Fees.</u> If any action is brought in a court of law by either party to this Agreement concerning the enforcement, interpretation or construction of this Agreement, the prevailing party, either at trail or upon appeal, shall be entitled to reasonable attorney's fees as well as costs, including expert witness's fees, incurred in the prosecution or defense of such action.
- 18. <u>Waiver</u>. The failure of either party to exercise any of its rights under this Agreement shall not be a waiver of those rights. A party waives only those rights specified in writing and signed by the party waiving its rights.
- 19. <u>Governmental Immunity</u>. The parties hereto understand and agree that Town is relying on, and does not waive or intend to waive by any provision of this Agreement, the monetary limitations or any other rights, immunities, and protections provided by the Colorado Governmental Immunity Act, Section 24-10-101, *et seq.*, C.R.S., as from time to time amended, or any other law or limitations otherwise available to Town, its officers, or its employees.
- 20. <u>Entire Agreement</u>. This Agreement constitutes the entire agreement and understanding between the parties hereto and supersedes any prior agreement or understanding relating to the subject matter of this Agreement. Any such prior agreement shall be deemed to be null and void and of no further effect.
- 21. <u>Modification</u>. This Agreement may be modified or amended only by a duly authorized written instrument executed by the parties hereto.
- 22. <u>Paragraph Headings</u>. Paragraph headings are inserted for convenience only and in no way limit or define the interpretation to be placed upon this Agreement.
- 23. <u>Terminology</u>. Wherever applicable, the pronouns in this Agreement designating the masculine or neuter shall equally apply to the feminine, neuter and masculine genders. Furthermore, wherever applicable within this Agreement, the singular shall include the plural, and the plural shall include the singular.
- 24. <u>Situs, Venue and Severability</u>. The laws of the State of Colorado shall govern the interpretation, validity, performance and enforcement of this Agreement. For the resolution of any dispute arising hereunder, venue shall be in the Courts of the County of Weld, State of Colorado. If any provision of this Agreement shall be held to be invalid or unenforceable, the validity and enforceability of the remaining provisions of this Agreement shall not be affected thereby.

25.	Authority Of Town.	This Agreemen	t is entered into	pursuant to	a Resolution	of the	Board (of Tr	ustees
of the	Γown of Erie, Colorado	adopted	, 201	7.					


[signatures on following page]


IN WITNESS WHEREOF, the parties hereto have entered into this Encroachment License Agreement as of the day and year first set forth above.

chool Board President
License Agreement was subscribed and sworn to before me this day of, School Board President, of Boulder Valley School District.
Notary Public
Address My Commission expires:

EXHIBIT "A"


(Exhibit Map of Town's Property and Encroachment)

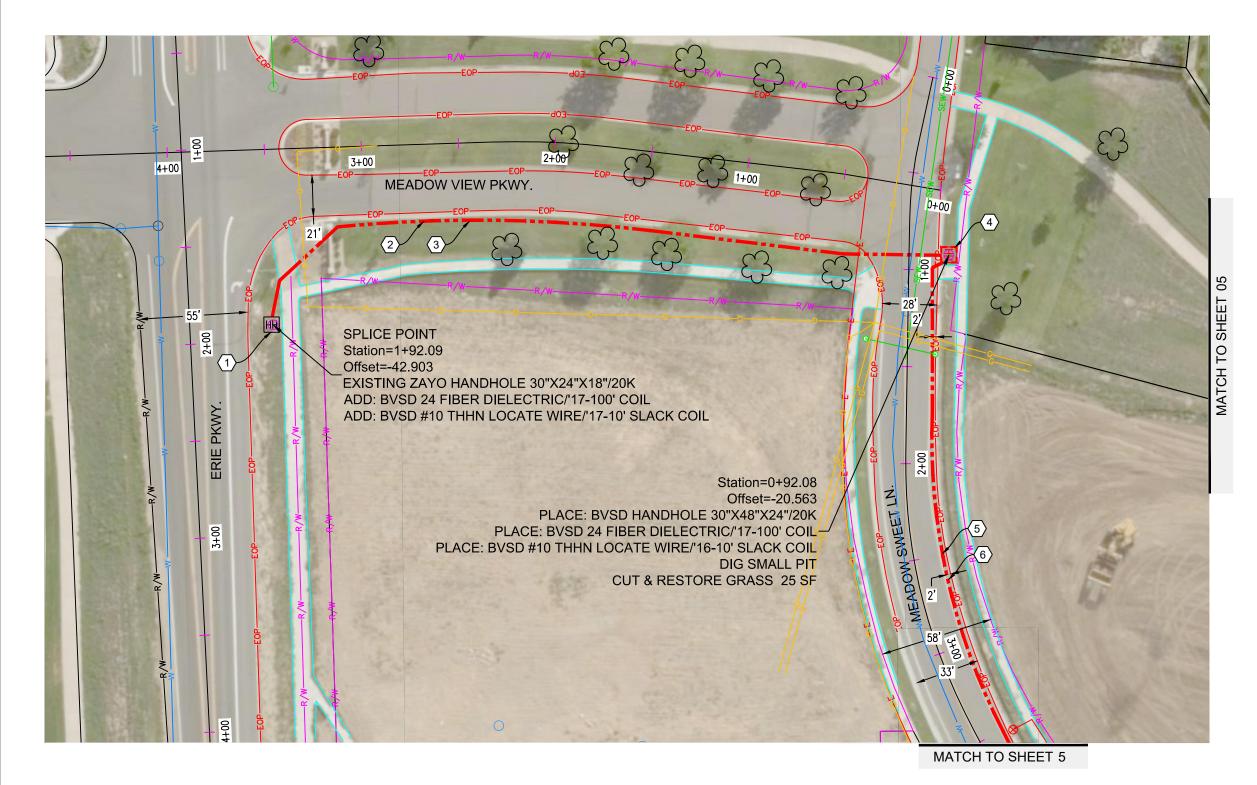

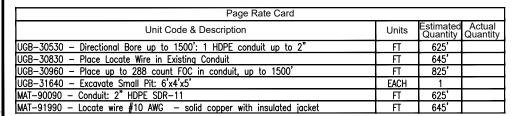





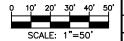

CONSTRUCTION NOTES

1 NEW SPLICE POINT EXISTING ZAYO 30"X24"X18"/HH

PLACE: BVSD 12 FIBER DIELECTRIC/'17-100' SLACK
PLACE: BVSD #10 THHN LOCATE WIRE/'17-10' SLACK

CONDUIT OWNER: BVSD
CONDUIT LENGTH: 372'
CONDUIT QTY: 1
CONDUIT SIZE: 2"
CONDUIT TYPE: SDR-11
DIRECTIONAL BORE 1-2" SDR-11/'17-372'

CABLE FIBERS: 48
CABLE OWNER: BVSD
CABLE LENGTH: 372'
NOTES: PLACE BVSD 12 FIBER DIELECTRIC/'17-372'
PLACE #10 THHN LOCATE WIRE/'17-372'

PROPOSED
BVSD 30"X48"X36"/20K HH
PLACE: BVSD 12 FIBER DIELECTRIC/'17-100' SLACK
PLACE: BVSD #10 THHN LOCATE WIRE/'17-10' SLACK

CONDUIT OWNER: BVSD
CONDUIT LENGTH: 253'
CONDUIT QTY: 1
CONDUIT SIZE: 2"
CONDUIT TYPE: SDR-11
DIRECTIONAL BORE 1-2" SDR-11/'17-253'

CABLE FIBERS: 48
CABLE OWNER: BVSD
CABLE LENGTH: 253'
NOTES: PLACE BVSD 12 FIBER DIELECTRIC/'17-253'
PLACE #10 THHN LOCATE WIRE/'17-253'



COMMUNICATION DESIGN GROUP CONSULTANTS, LLC 7255 W. 97TH PLACE WESTMINSTER, CO 80021 PHONE-303.548.1379

Ü	DGC					
3		BWL	BWL	AS-BUILT		
2		BWL	BWL	REVISION # 1		
1	05/01/17	BWL	BWL	ORIGINAL		
NO.	DATE	ENG DESIGN	DRAFTING	COMMENT		




PROJECT ENGINEERBWL
ENGINEERING FIRM: CDGC 303.548.1379
PROJECT NUMBER: 017-00000
LOCATION: 2300 Meadow Sweet Lane Erie, CO 80516

DRAWING NAME: RB_BVSD-REV.dwg


ETARY


SHEET: 04 OF 07

DWG: C:\Proj

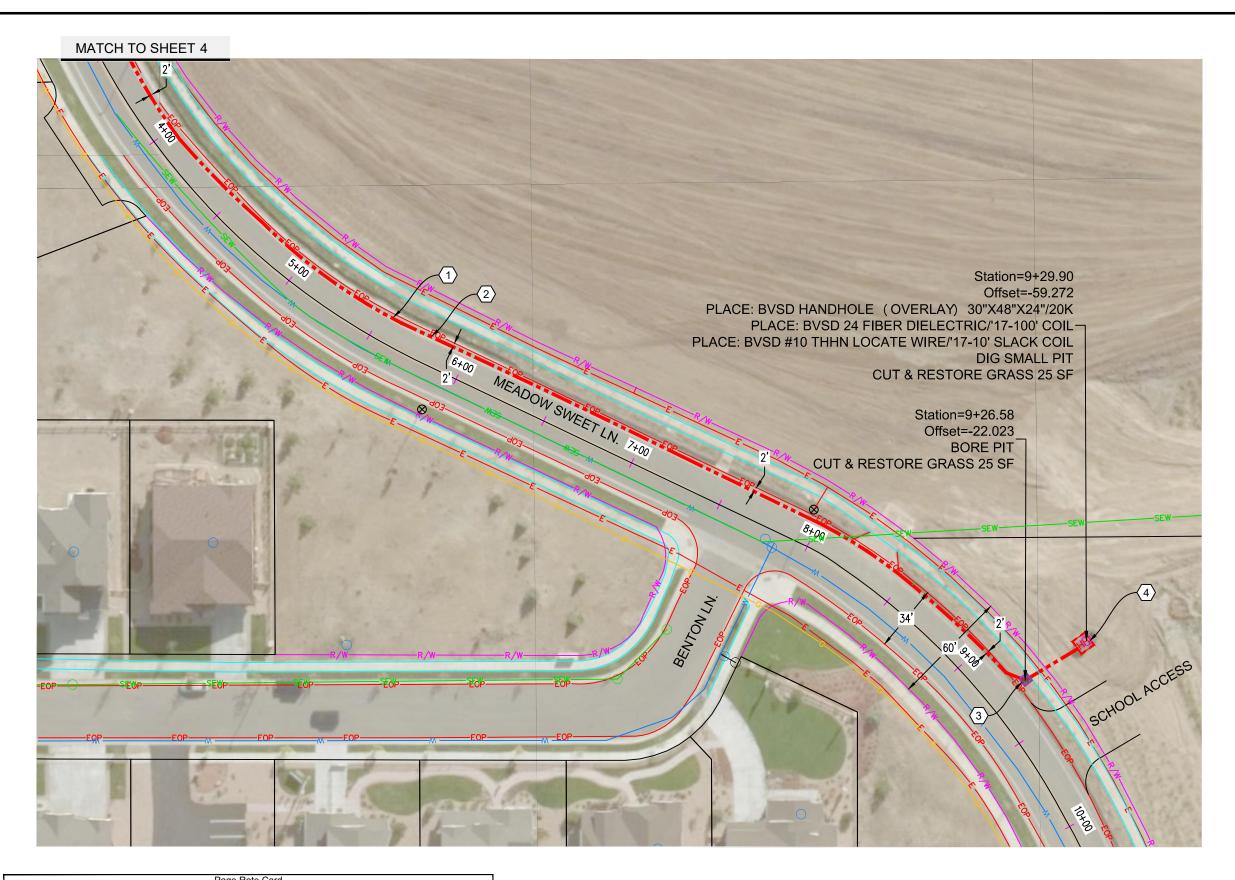

Page Rate Card			
Unit Code & Description	Units	Estimated Quantity	Actual Quantity
UGB-30530 - Directional Bore up to 1500': 1 HDPE conduit up to 2"	FT	593'	
UGB-30830 - Place Locate Wire in Existing Conduit	FT	603'	
UGB-30960 - Place up to 288 count FOC in conduit, up to 1500'	FT	693'	
UGB-31640 - Excavate Small Pit: 6'x4'x5'	EACH	2	
MAT-90090 - Conduit: 2" HDPE SDR-11	FT	593'	
MAT-91990 - Locate wire #10 AWG - solid copper with insulated jacket	FT	603'	

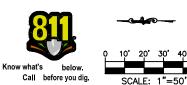

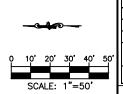

CONSTRUCTION NOTES

CONDUIT OWNER: BVSD CONDUIT LENGTH: 593' CONDUIT QTY: 1 CONDUIT SIZE: 2" CONDUIT TYPE: SDR-11
DIRECTIONAL BORE 1-2" SDR-11/'17-593'

CABLE FIBERS: 48
CABLE OWNER: BVSD
CABLE LENGTH: 593' NOTES: PLACE BVSD 12 FIBER DIELECTRIC/'17-593' PLACE #10 THHN LOCATE WIRE/'17-593'

BORE PIT CUT & RESTORE GRASS 25 SF

BVSD-27J-09 30"X48"X36"/20K HH PLACE: BVSD 12 FIBER DIELECTRIC/'17-100' SLACK PLACE: BVSD #10 THHN LOCATE WIRE/'17-10' SLACK



COMMUNICATION DESIGN GROUP CONSULTANTS, LLC 7255 W. 97TH PLACE WESTMINSTER, CO 80021 PHONE-303.548.1379

3		BWL	BWL			
2		BWL	BWL			
1	05/26/17	RWI	RWI			



PROJECT ENGINEERBWL

LOCATION: 2300 Meadow Sweet Lane Erie, CO 80516

ENGINEERING FIRM: CDGC 303.548.1379 PROJECT NUMBER: 017-00000

DRAWING NAME: RB_BVSD-REV.dwg

SHEET: 05 OF 07

AS-BUILT REVISION # 1 ORIGINAL

EXHIBIT "B"

(Boulder Valley School District, Meadowlark School Fiber Optic Plans)

Included by reference